



AS-BUILTS

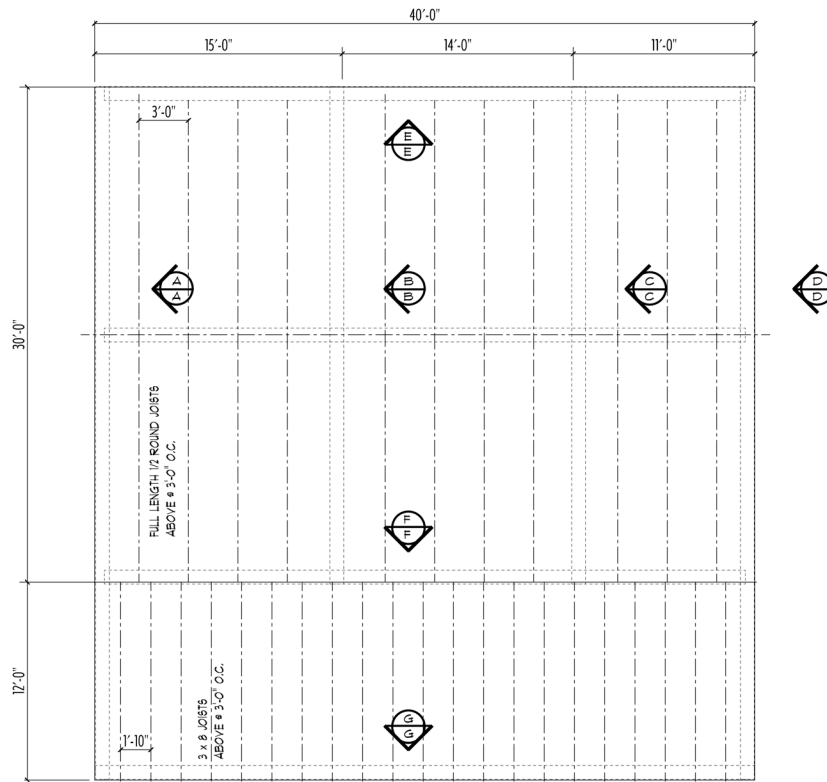


SILL PLAN
SCALE: 3/16" = 1'-0"

1870'S FRAME

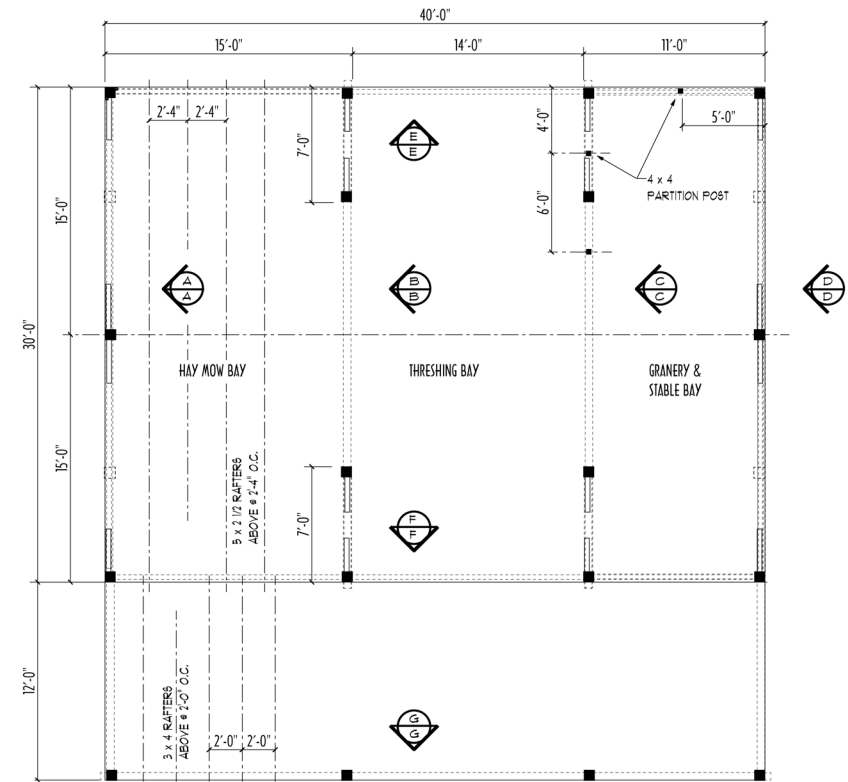

MAIN FLOOR PLAN
SCALE: 3/16" = 1'-0"
PROJECT SQ FOOTAGES:
1,660 SQ. FT.

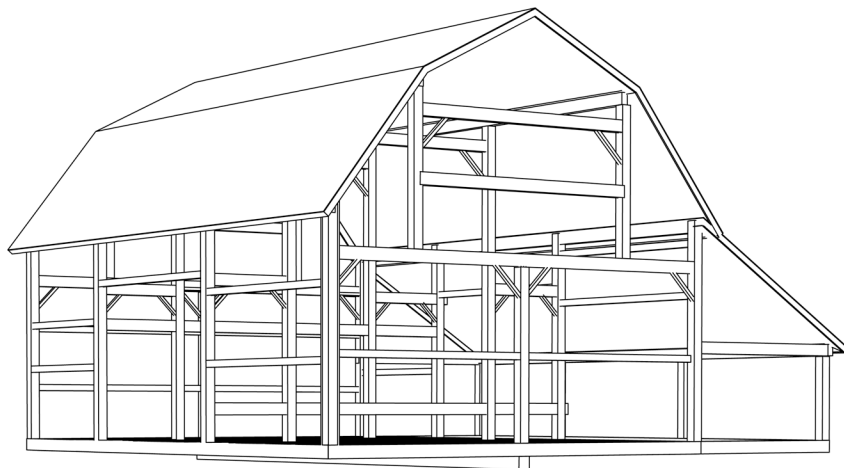

OWEGO NEW MILFORD TRPK FRAME
FOREST LAKE, PA

AS-1

June 02, 2011